





573/4 '5.  
Profile

7 plans

and 574-5  
per London Letter  
26/11/35.

✱ ST HELENA Sld 31859.  
ST MARGARET

"St. Clears."

M<sup>r</sup> Konsul hantz

SUNDERLAND RPT. NO. 31928

PLANS TRANSFERRED  
TO SISTER VESSEL

Novelg ✓  
MR



© 2021

Lloyd's Register  
Foundation

011936-011939-0004







W1153-0067

SUNDERLAND.

Messrs. J. L. Thompson & Son Ltd

No 573.  
+ "St. Helena" +  
SLD. 31859.

Profile.  
(as built)




RETAIN



© 2020

Lloyd's Register  
Foundation



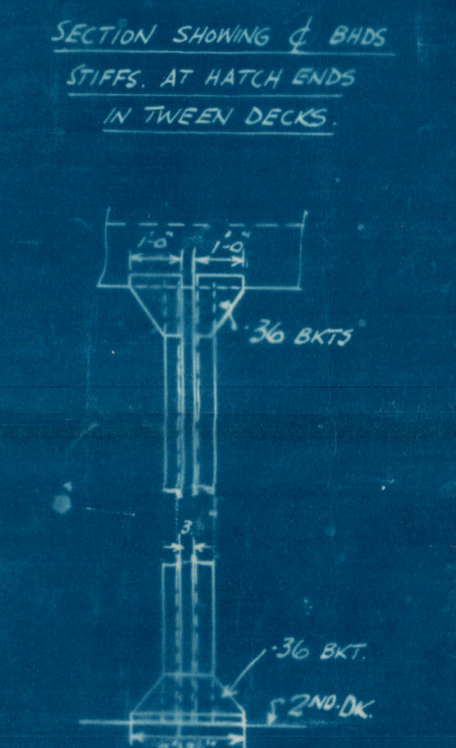



— SUNDERLAND. —

MESSRS. J. L. THOMPSON & SONS

No. "573 1/4 / 5."

DECK PLANS.

Sld 31859

ST HELENA

ST MARGARET

*for 574-5 N/W 'Kansel hints'*

*for London Letter*

*27/11/35*



*St. Clears*

SUNDERLAND RPT. No. 31928

PLANS TRANSFERRED  
TO SISTER VESSEL




011936-011939-0003

Lloyd's Register  
Foundation



389'-0" BP, 56'-0" B<sup>OTH</sup> EXT, 33'-10" D<sup>PTH</sup> MID UPPER DK  
COMPLETE SUPERSTRUCTURE TYPE WITH FREEBOARD  
LLOYDS 100A CLASS

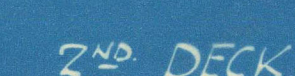



573 1/4 / 5

7 and 10

Longitudinal framing

x

7 plume

Double Bottom with Long  
and 5 1/4 - 5 framing

per London Letter

97/11/35



ST HELENA Sld 31859

ST MARGARET

"St. Clears"

SUNDERLAND RPT. NO. 31928

PLANS TRANSFERRED  
TO SISTER VESSEL

W 5 1/2

Novely



© 2021

Lloyd's Register  
Foundation

011936-011939-0005





7/11/35

# S.S. No 573

PLAN SHOWING ALTERNATIVE ARRANGEMENT OF  
DOUBLE BOTTOM WITH LONGITUDINAL FRAMING.

SCALE: 1/8" = 1 FOOT.

SEE SEPARATE PLAN FOR SIZES OF LONGITUDINALS, BRACKETS, ETC.

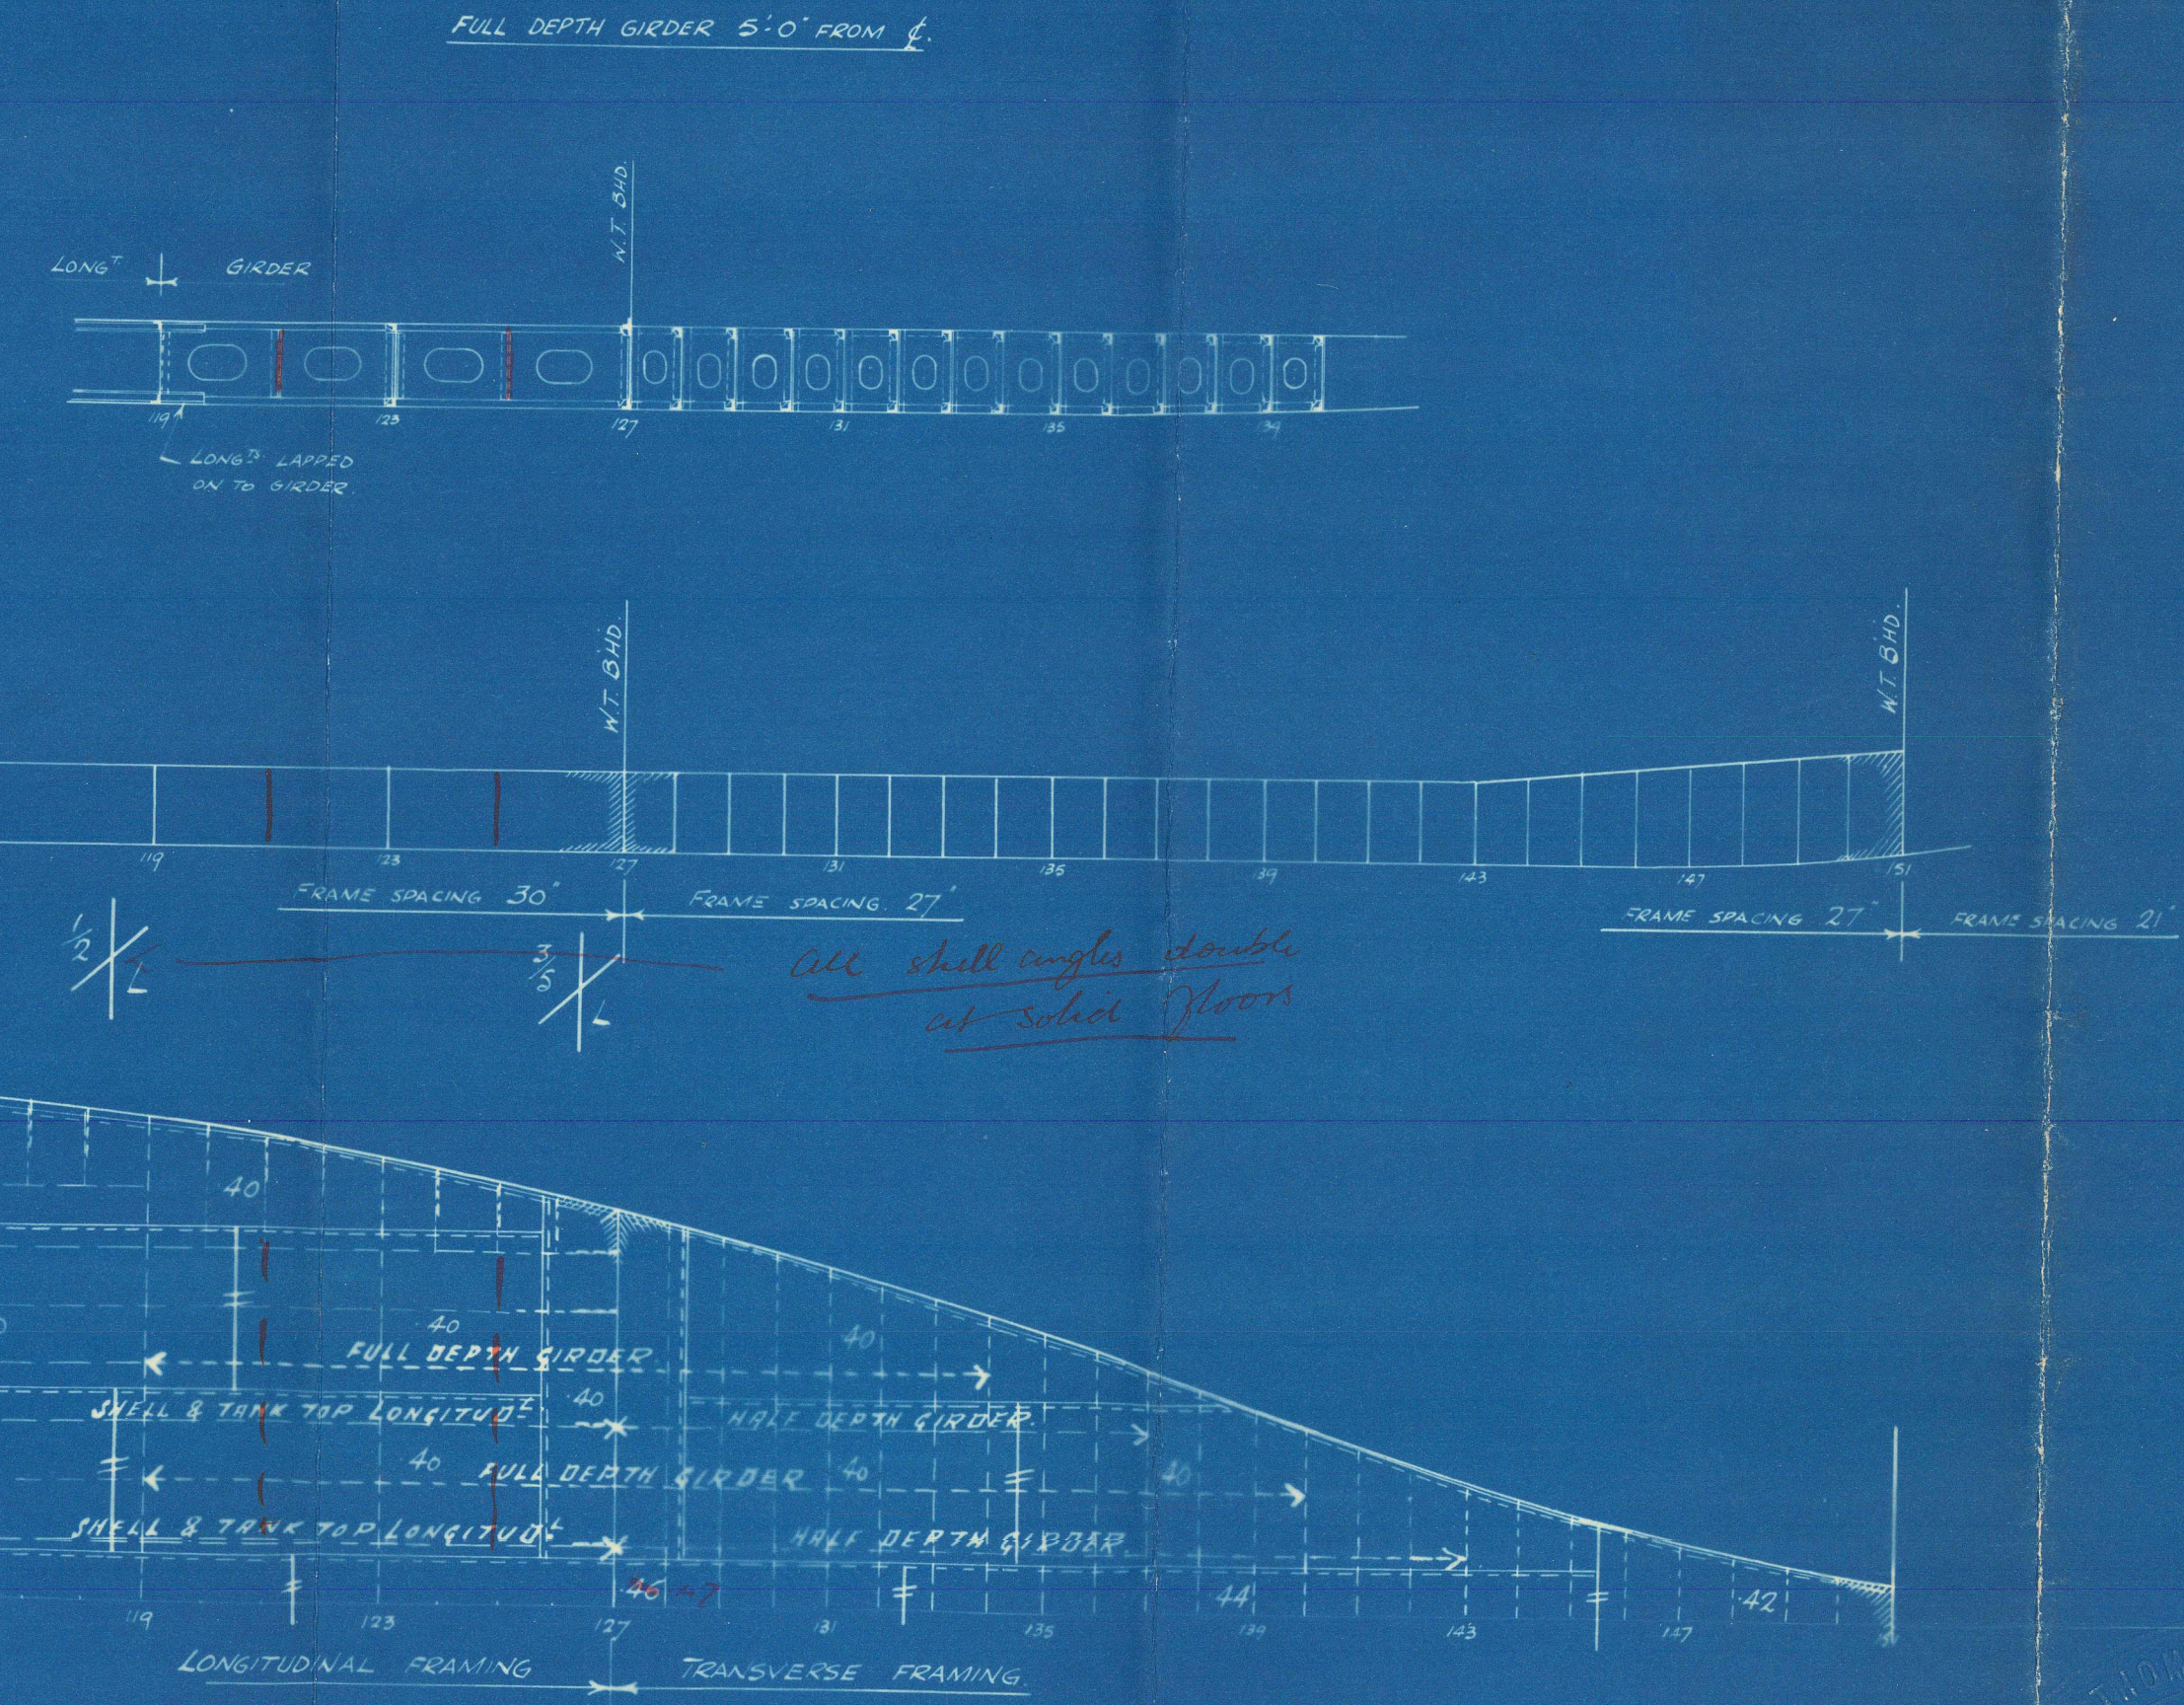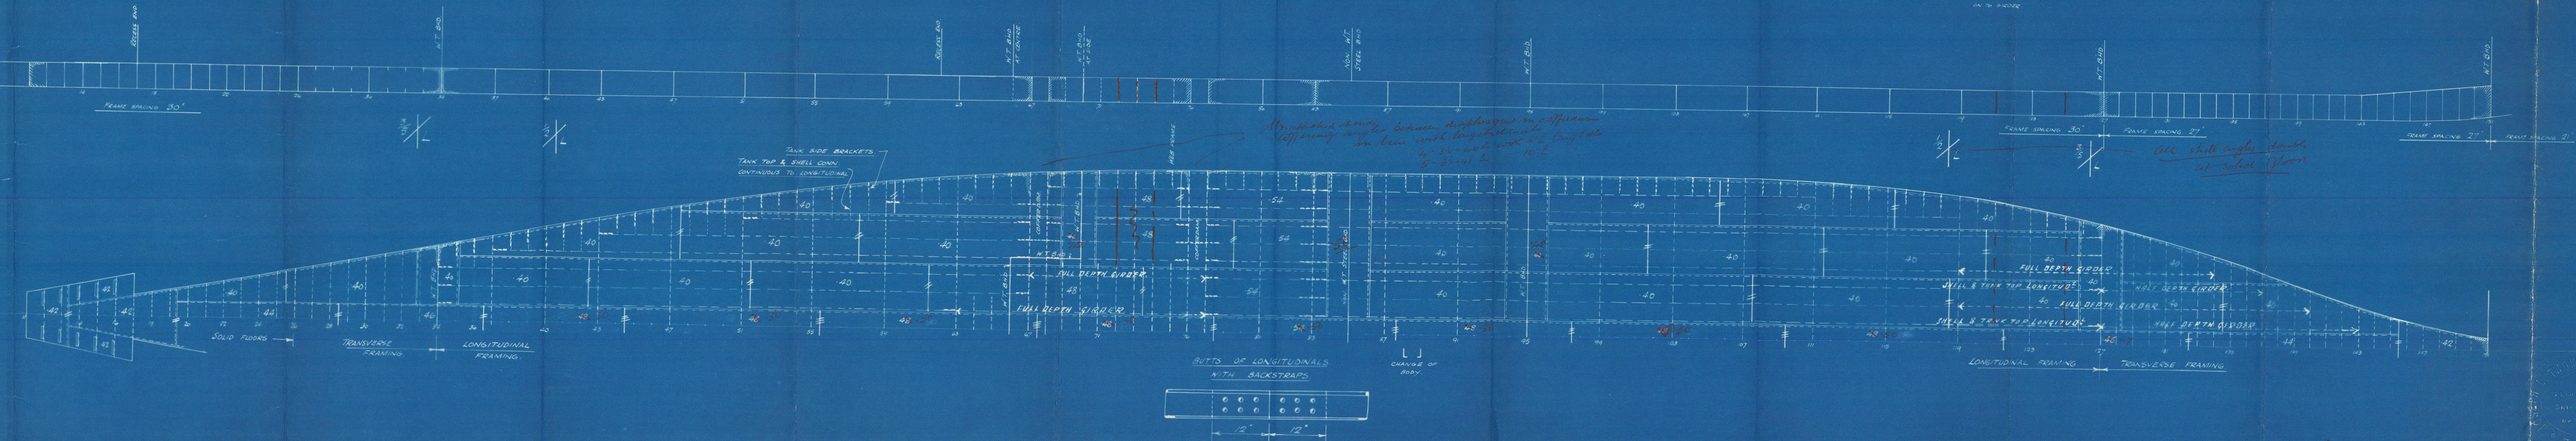

*Attached at ends between diaphragms in upper part of hull in line with longitudinal 4-34-002 with 6\"/>*

*All shell angles double at solid floors*

THOMPSON & SONS  
DRAWING NO. 10389  
SHIP NO. 573  
DATE 30/10/35  
SUNDERLAND

011936-011939-0005



573/4/5.

Section

*7 plans.*

*and 574 & 5*

*for Lander Litter*

*27/11/35.*



ST HELENA

Sld. 31859.

ST MARGARET

"St. Clears."

*W. Konrad hantz*

BUNDERLAND RPT. NO. 31928

PLANS TRANSFERRED  
TO SISTER VESSEL

*Gorely*  
~~14-8-118~~



© 2021

Lloyd's Register  
Foundation

011936-011939-0002







✓ W.S. 110 X

SUNDERLAND

W1153-0068

Messrs. J. L. Thompson & Sons, Ltd.

No 573.

"St Helena" Sld 31859

Midship Section.  
(as built)



~~PLANS TRANSFERRED~~  
~~TO SISTER VESSEL~~

RETAIN



© 2020

Lloyd's Register  
Foundation







— SUNDERLAND. —

MESSRS. J. L. THOMPSON & SONS.

No. 573/4/5.

ALTERNATIVE STERN FRAME

AND

BALANCED REACTION RUDDER.



*and 574-5*

*Per London Letter*

*27/11/38*



ST HELENA SLD. 31859.

ST MARGARET

*Ut. bears*

SUNDERLAND RPT. NO. 31928

PLANS TRANSFERRED  
TO SISTER VESSEL



© 2021

Lloyd's Register  
Foundation

011936-011939-0006



